



52 Starr Ridge Road
Brewster NY 10509

Successor to Robert H. Bergendorff, James C. Edgett, William Alexander
www.TerryBergendorffCollins.com

T 845 279 4261
F 845 279 6838

February 5, 2021

Ms. Jessica O'Rourke
Broadcast Technician
WAMC Northeast Public Radios


Sent via email to jorourke@wamc.org

RE: 250 Harris Road
Bedford Hills, New York


Dear Ms. O'Rourke:

I, Terry Bergendorff Collins, PLS # 49691, a professional land surveyor licensed in the State of New York, hereby certify that all three installed antenna are oriented within 1 degree of the true north azimuths as noted on the Shively Labs Long Periodic Antenna Installation plan S37233-2, dated June 24, 2020. I have attached a sketch, "Radio Tower Leg Locations, last revised 1/18/2021, indicating the same.


Respectfully,

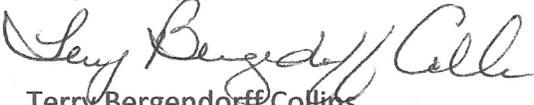
Terry Bergendorff Collins

G:/Letters.Clients/WAMC Radio.0205.21

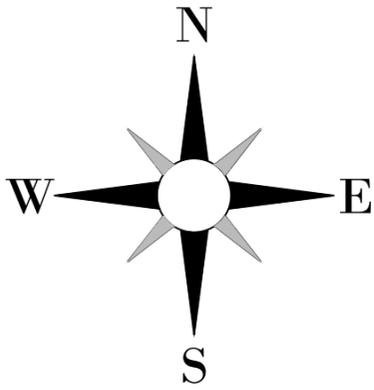

N:879999.5292'
E:718935.2182'
Z:395.54'
LEG A

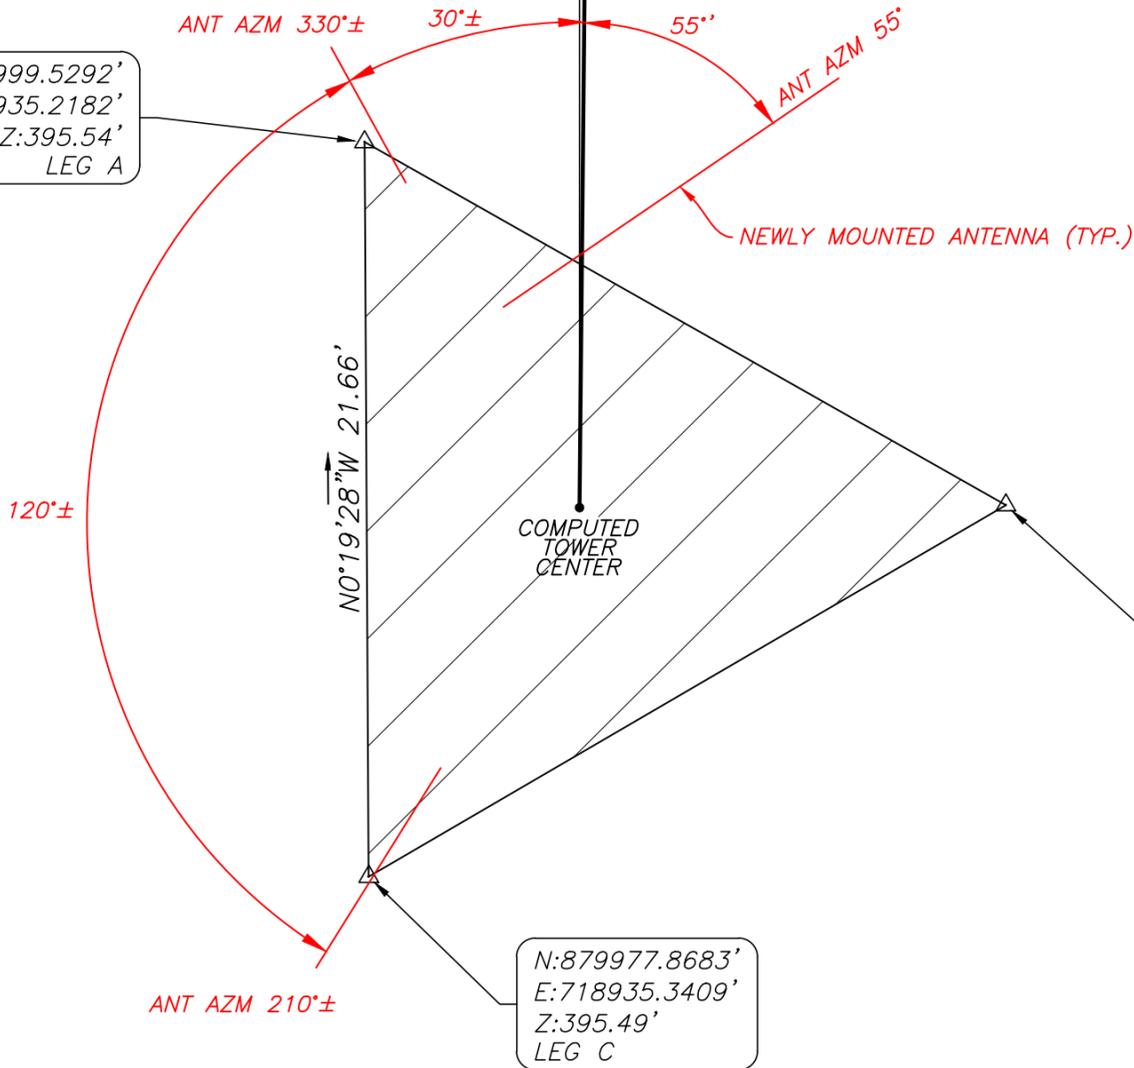

N:879988.8232'
E:718954.0397'
Z:395.49'
LEG B

N:879977.8683'
E:718935.3409'
Z:395.49'
LEG C

GENERAL NOTES:

1. HORIZONTAL DATUM: NAD83, NEW YORK STATE PLANE, EAST ZONE, US FOOT
2. VERTICAL DATUM: NAVD88.
3. TOWER LEGS AT BASE PER FIELDWORK COMPLETED 5/27/2020. PROJECT COORDINATES REFERENCE GRID NORTH.
4. ANTENNA ORIENTATION AS-BUILT PER FIELDWORK COMPLETED 1/12/2021 & 1/18/21. ANTENNA AZIMUTHS REFERENCE TRUE NORTH @ 74°30'00" WEST.

REVISIONS

DATE	DESCRIPTION	BY
1/12/21	ANTENNA ORIENTATION AS-BUILT	JJ
1/18/21	ANTENNA ORIENTATION AS-BUILT	JJ

RADIO TOWER LEG LOCATIONS

PREPARED FOR

WAMC NORTHEAST PUBLIC RADIO

SITUATE IN

TOWN OF BEDFORD
SCALE: 1" = 5'

WESTCHESTER CO., N.Y.
MAY 27, 2020

COPYRIGHT © 2020 TERRY BERGENDORFF COLLINS, ALL RIGHTS RESERVED

SURVEYOR'S SEAL



N.Y.S. LICENSE NO. 49691

THE ALTERATION OF SURVEY MAPS BY ANYONE OTHER THAN THE ORIGINAL PREPARER IS MISLEADING, CONFUSING AND NOT IN THE GENERAL WELFARE AND BENEFIT OF THE PUBLIC. LICENSED LAND SURVEYORS SHALL NOT ALTER SURVEY MAPS, SURVEY PLANS OR SURVEY PLATS PREPARED BY OTHERS. UNAUTHORIZED ALTERATION OR ADDITION TO THIS SURVEY IS A VIOLATION OF SECTION # 7209 OF THE NEW YORK STATE EDUCATION LAW. THE LOCATION OF UNDERGROUND IMPROVEMENTS OR ENCROACHMENTS, IF ANY EXIST OR ARE SHOWN HEREON ARE NOT CERTIFIED. ALL CERTIFICATIONS HEREON ARE VALID FOR THIS MAP AND COPIES THEREOF ONLY IF SAID MAP OR COPIES BEAR THE IMPRESSED SEAL OF THE SURVEYOR WHOSE SIGNATURE APPEARS HEREON. THIS MAP MAY NOT BE USED IN CONNECTION WITH A "SURVEY AFFIDAVIT" OR SIMILAR DOCUMENT, STATEMENT OR MECHANISM TO OBTAIN TITLE INSURANCE FOR ANY SUBSEQUENT OR FUTURE GRANTEEES.

PREPARED BY THE OFFICE OF:

Terry Bergendorff Collins
TERRY BERGENDORFF COLLINS

52 STARR RIDGE ROAD
BREWSTER, NEW YORK 10509
P:845.279.4261 F:845.279.6838
WWW.TERRYBERGENDORFFCOLLINS.COM

FIELD PARTY: DM DRAWN BY: DM CHECKED BY: TBG

JOB NO. BEDFORD 60.12-1-1