


Permitted Radiation Pattern Envelope (RPE) versus
As-Built Jampro DA Pattern

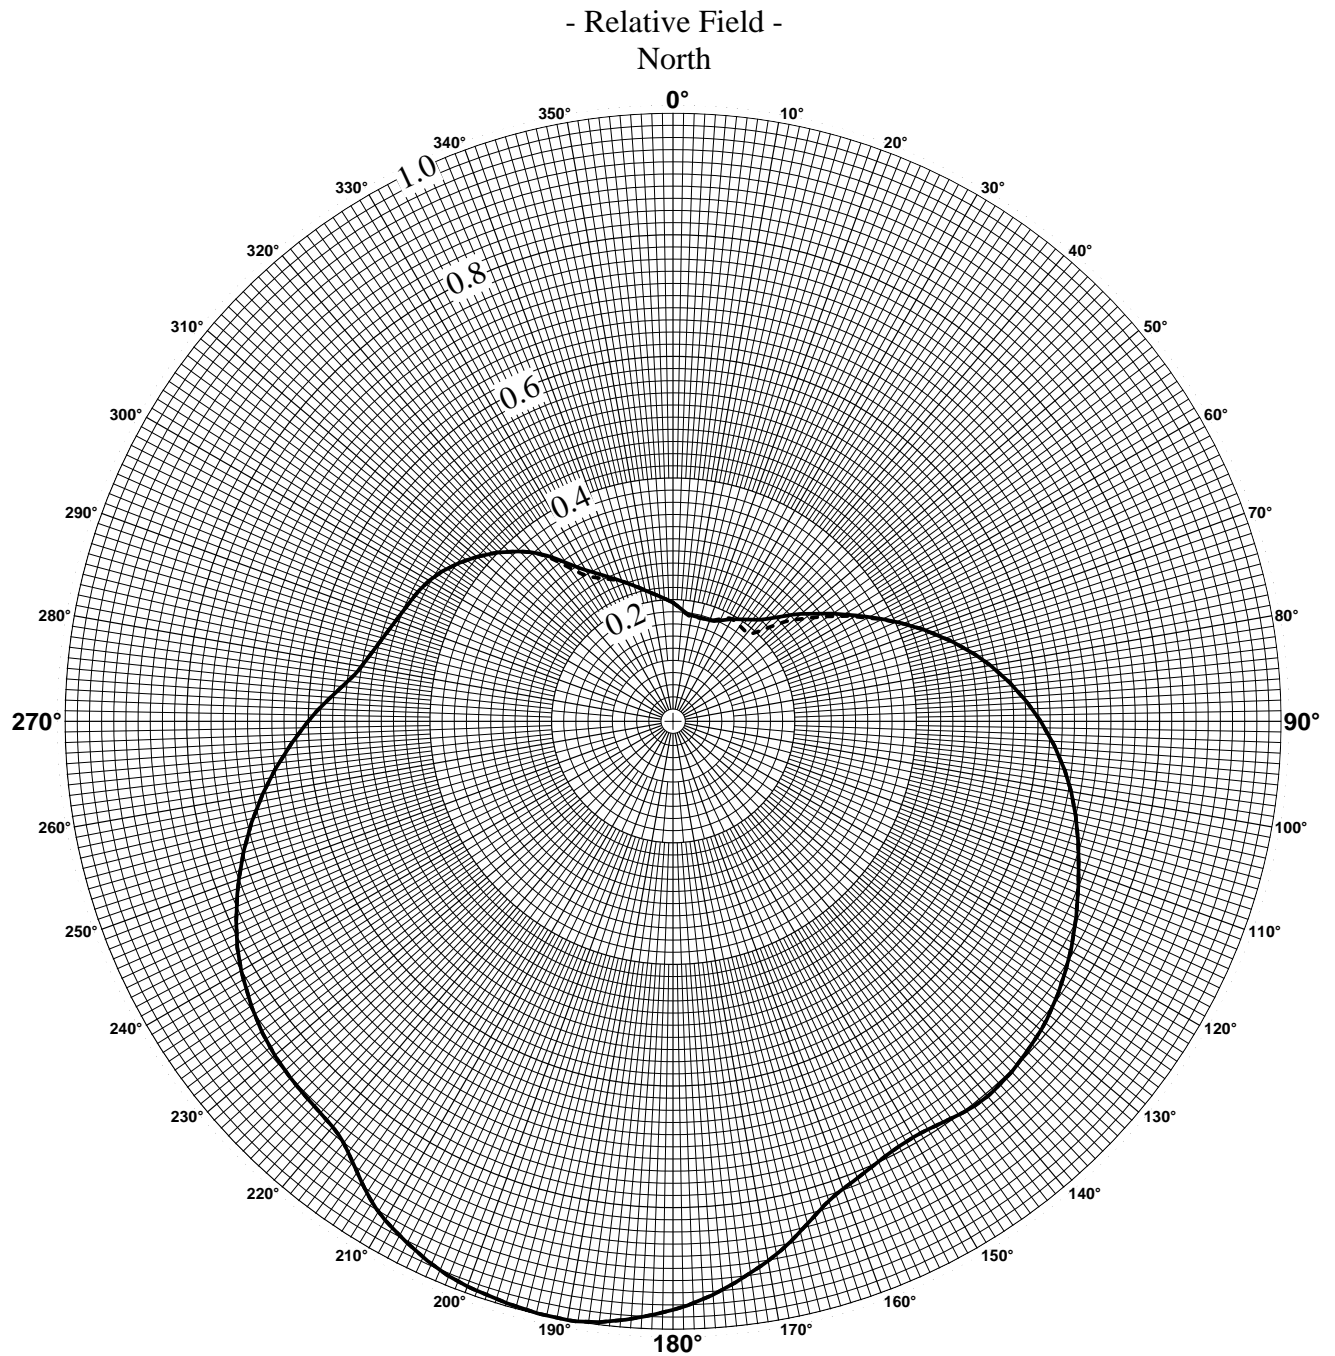

As-built DA RMS = 1.281

RPE RMS = 1.284

As-built/RPE = 99.8%

— = RPE
----- = Jampro Model JMPC-1-57.5/42.5-R-DA Pattern

