


DIRECTIONAL ANTENNA INSTALLATION
AS-BUILT AZIMUTH EXHIBIT
SITE ADDRESS: 4033 FISHER ROAD
QUAD MAP: SOUTHWEST COLUMBUS, OHIO

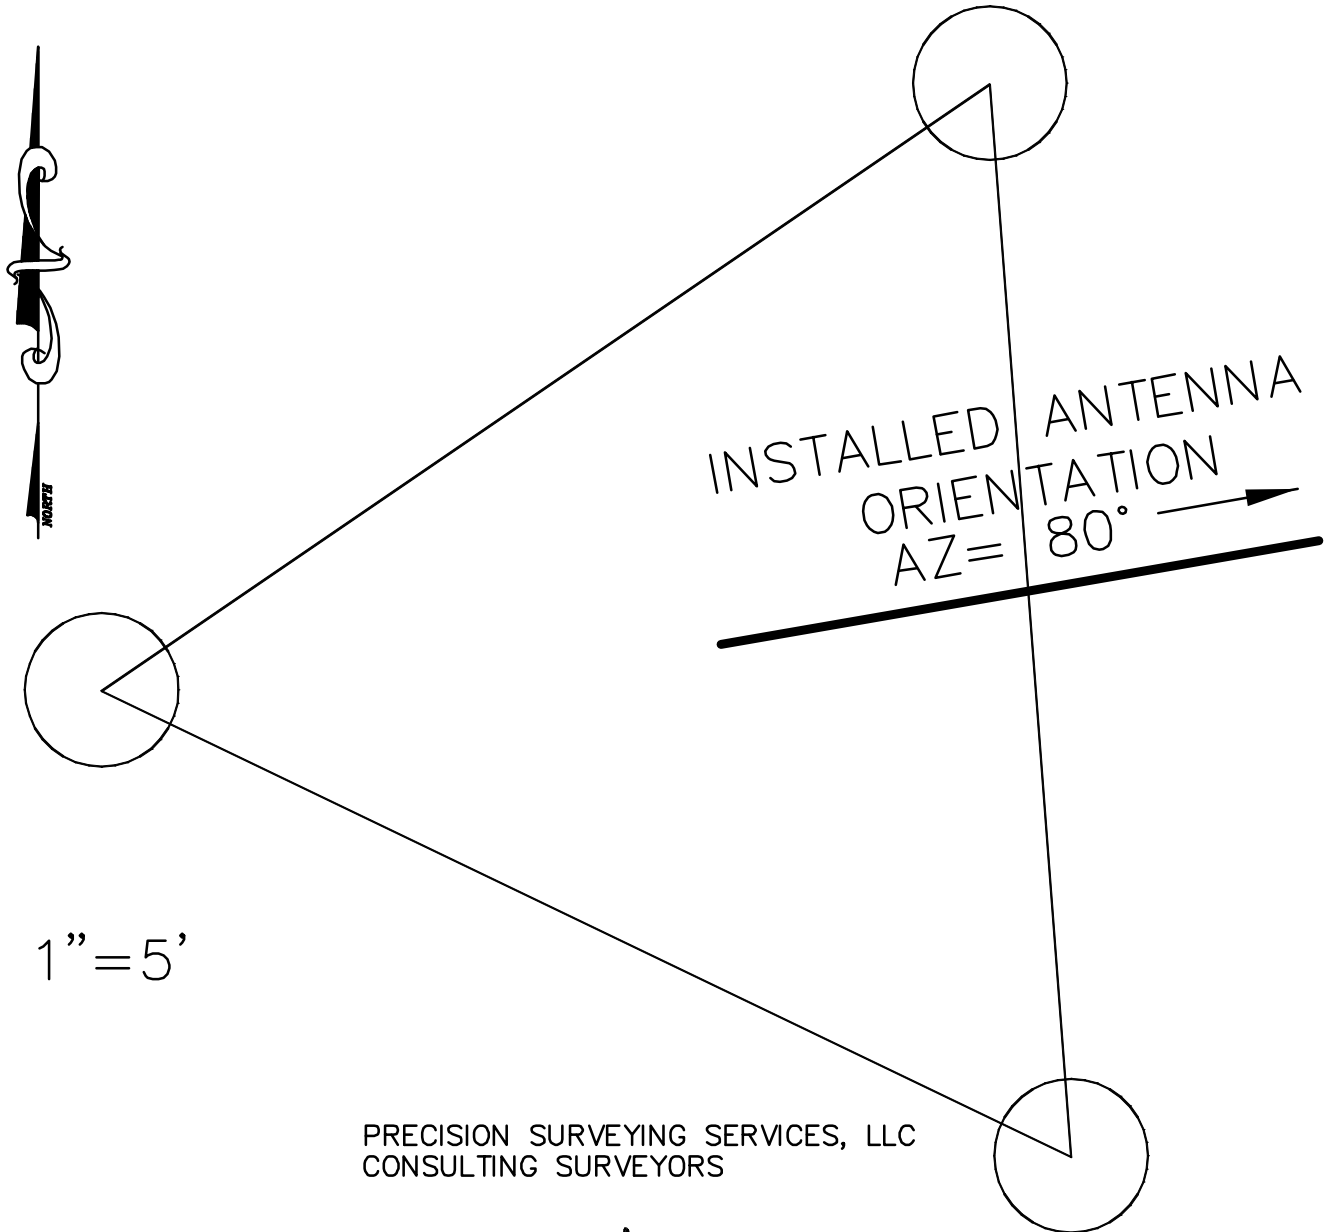

PRECISION SURVEYING SERVICES, LLC
CONSULTING SURVEYORS



SIGNED: John W. Evers AUGUST 15, 2013
JOHN W. EVERS, P.S. NO. 7869